

GREENVILLE UTILITIES COMMISSION

ADDENDUM 1 FOR 26-31

RFB FOR PAINTING

5/26/2026 @ 2:30 PM

To: All Prospective Proposers and Others Concerned.


Subject: Addendum No.1

The intent of this addendum is to notify all prospective proposers and others concerned that the Specifications and Documents are hereby modified as follows:

- All rooms/walls inside red outline of floor 2 shall have the wallpaper removed and prepped for the Wall contractor to level 5 each wall. After the other contractor level 5 prepares all surfaces this scope shall paint all walled surfaces.
- Areas inside or marked in green are either new walls or do not have wallpaper and should be painted only.

The foregoing changes shall be incorporated in the Specifications and Documents.

Please acknowledged receipt of this addendum by e-mailing Cleve Haddock, Purchasing Department, Procurement Manager at: haddocgc@guc.com (252) 551-1533.

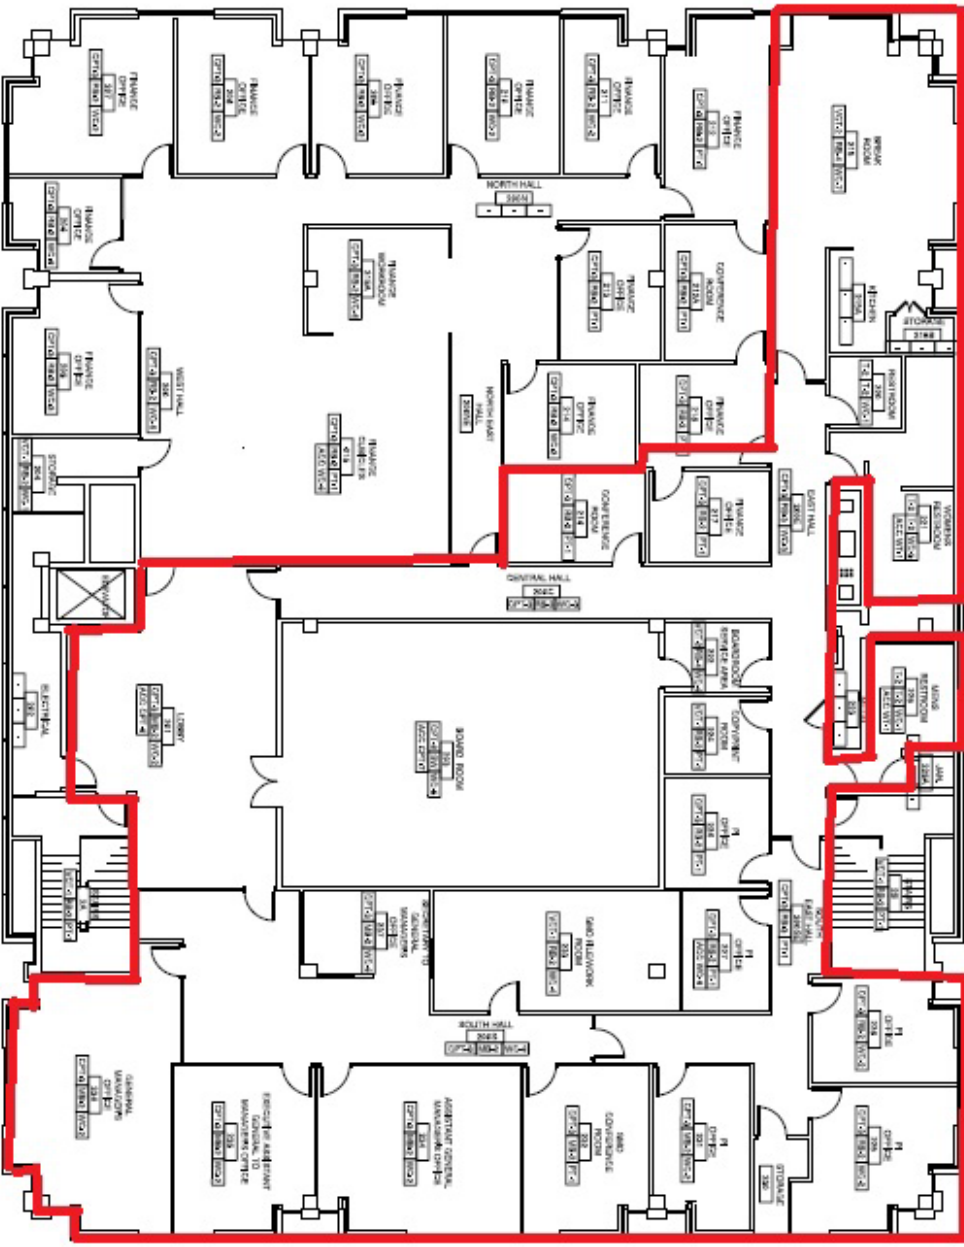

Painting


SECOND FLOOR FINISH PLAN 1

A9-2

PROJECT: GREENVILLE UTILITIES COMMISSION
 PROJECT # 2018-001
 SHEET # A9-2

Greenville Utilities Commission
Life Safety, Ceiling,
& Finish Plans
 401 South Greene Street
 Greenville, North Carolina



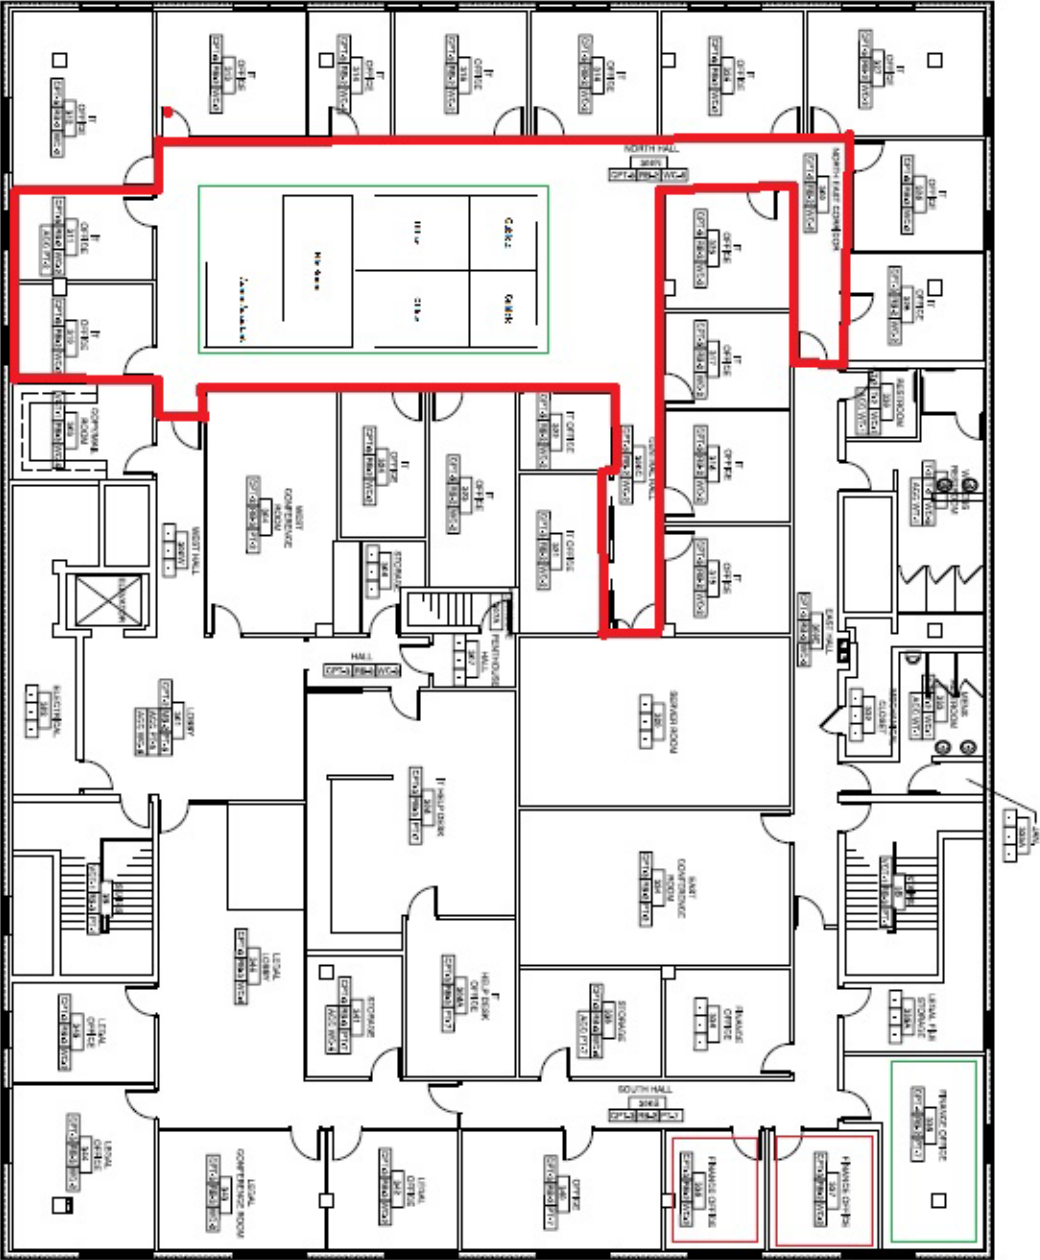

THIRD FLOOR FINISH PLAN 1



Greenville Utilities Commission
Life Safety, Ceiling,
& Finish Plans
 431 South Greene Street
 Greenville, North Carolina

PROJECT: LIFE SAFETY, CEILING, & FINISH PLANS
 SHEET: THIRD FLOOR FINISH PLAN
 DATE: 08/15/2018
 DRAWN BY: MHA
 CHECKED BY: MHA
 PROJECT MANAGER: MHA
 ARCHITECT: MHA
 SHEET NUMBER: **A9-3**

